


OFFICE OF THE MARION COUNTY SURVEYOR  
SECTION RECORD CORNER  
SECTION 15 TOWNSHIP 14 RANGE 3  
DATE: 10-28-05  
PARTY CHIEF: Wilcoxon  
CREW: \_\_\_\_\_  
TYPE OF MARKER: Harrison over brass plug 24" dn  
METHOD OF ESTABLISHMENT: County: 1-8-00

IN. S.P.C. E ZONE NAD '83  
NAME: 14031501  
N: 490301.3951(m)  
E: 54531.4902(m)

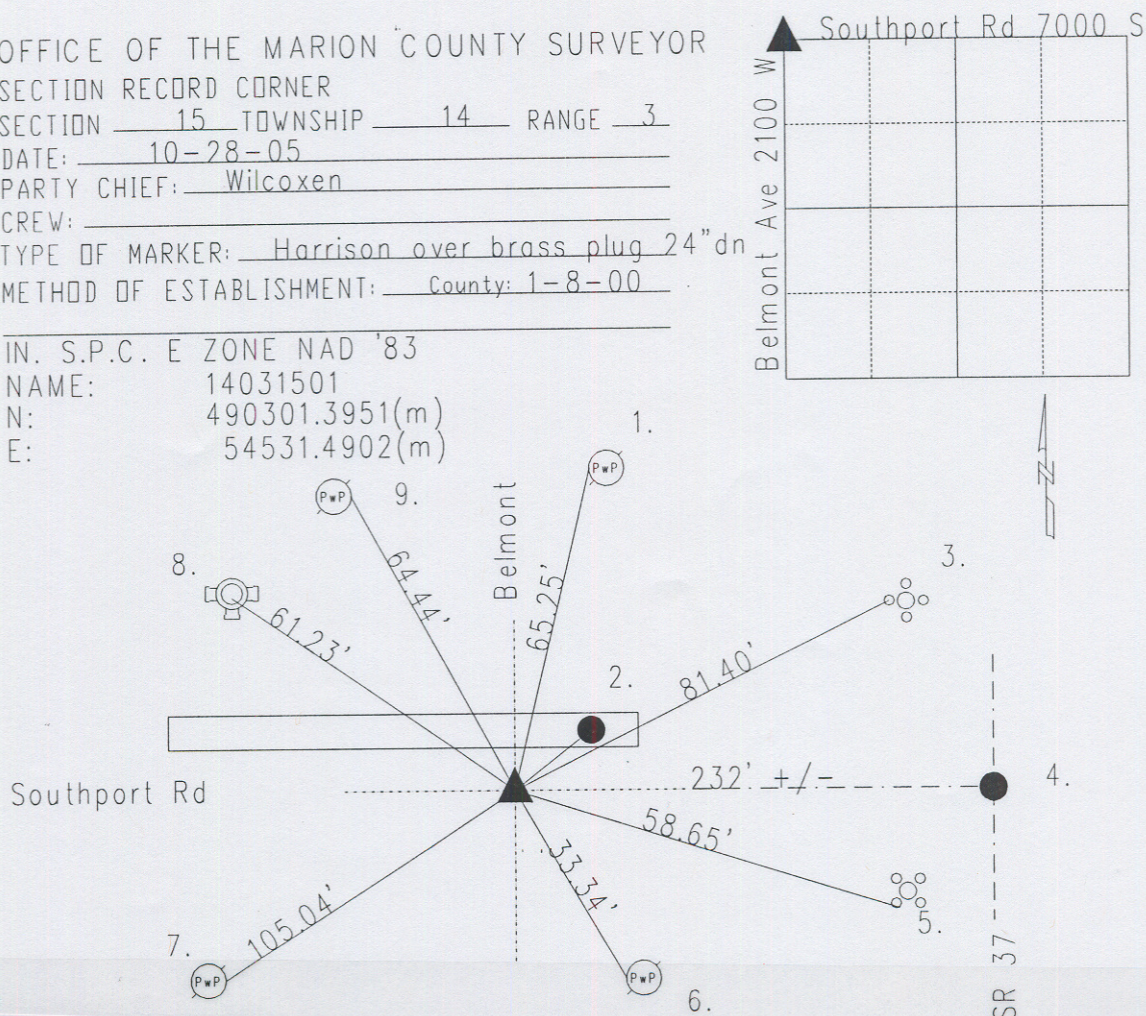

#### 14031501 NW corner

**CORNER HISTORY:** Corner originally set as a post in 1820 by Wm. B. Laughlin with witness: 4" hackberry N 88 E 4 links; 14" white oak N 73 W 14 links per Marion County Atlas pg. 5. A survey dated 5-17-1869 called stone with witness: 9" apple tree S 54  $\frac{3}{4}$  E 73 links per Perry Township Legal Survey Book pg. 26. Old tie card dated 7-15-1946 by Monroe called stone dug up. Reference dated 5-7-1954 by Monroe called pipe over stone. Reference dated 11-20-59 called same. Reference dated 6-19-1975 by Miller called a cut 'x' in steel box as NE corner of 16-14-3. Reference dated 6-30-86 by Greene called cut 'x' in steel box. Reference dated 12-20-95 by Kiste called set a tack over steel box. Reference dated 1-8-00 by Kiste called set a PK nail. Reference dated 10-25-05 by Wilcoxon called found brass plug in steel box 24" down. Straddles were good set Harrison over brass plug.

REF.	DISTANCE	DESCRIPTION
1.	65.25'	Mag nail w/bw W PwP#16-751 36"up
2.	20.50'	Mag w/washer joint concrete median
3.	81.40'	Cut 'x' W-bolt of aluminum pole base
4.	232' +/-	East to SR 37 Centerline
5.	58.65'	Cut 'x' SW-bolt aluminum pole base
6.	33.34'	Mag w/washer W PwP#32-752 12"up
7.	105.04'	Mag nail w/washer F PwP#185-751 36"up
8.	61.23'	Top nut of fire hydrant
9.	64.44'	Mag nail w/brass washer F PwP#619-751 24"up